LABOR AND MATERIALS

1	Copper Lead — Connection	1" COP. TO COP. S.T. W.	$ 4.70
1	Curb — Cock / ~~Valve~~ / T. S. & V.	1 in.	$ 5.37
1	Service box — Old returned — Short 3½x4½ / Long 4½x5½ / Buff or Rdway		$ 4.70
22	Ft. 1 in. — Copper / ~~C. I.~~ / ~~C. I.~~ Pipe at 43		$ 8.89
	Nipples in. at		$
	Bushings to in. at		$
	Red'g / Inc'g — Coupl'gs to in. at		$
	Union in. at		$
	Meter in. at		$
	Lead Joints at		$
	Compound Joints at		$
8	Hrs. Water Maint. Man—1 at		$
7	Hrs. Water Maint. Man—2 at 1.13		$ 9.04
36	Hrs. ~~Labor~~ AM at 1.26		$ 8.82
3	Hrs. Labor— at 1.02		$ 36.72
	Hrs. Compressor at 1.50		$ 4.50
	Compensation Ins. at $2.66 per C.		$ 1.45
	Trucking		$ 1.00
	Pav't Patch		$ 13.44
			$
			$
			$
	O'head		$
	Tap made by Fisford 4-17-51		$ 99.53

St. ~~Pl.~~ Ave. No. 67

Park

Name of Owner

Sullivan & Minahan

Labor and Mat'l. Report April 17 1951

RAZED 1999

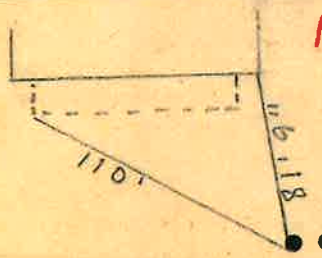

SHUT OFF CURB - 2-22-99

6" Main

Elev. of Main at tap 5'

Gate at ●

● Gate at

● Curb Box

LSM-5C 10-21-49