LABOR AND MATERIALS

1	Copper Lead — Connection	3/4"	$ 2.76
1	Curb — Cock / ~~Valve~~ / ~~T. S. & V.~~	3/4 in.	$ 3.49
1	Service box — Old returned — Short 3½x4½ / Long 4½x5½ / Buff or Rdway		$ 4.75
24	Ft. 3/4 in. — Copper / ~~G. I.~~ / ~~C. I.~~ — Pipe at 35		$ 8.40
	Nipples	in. at	$
	Bushings	to in. at	$
	Red'g / Inc'g — Coupl'gs	to in. at	$
	Union	in. at	$
	Meter	in. at	$
	Lead Joints at		$
	Compound Joints at		$
	Hrs. Water Maint. Man—1 at		$
16	Hrs. Water Maint. Man—2 at	1.24	$ 19.84
16	Hrs. Labor—	at 1.13	$ 18.08
	Hrs. Labor—	at	$
2	Hrs. Compressor at	1.50	$ 3.00
	Compensation Ins. at $3.06 per C.		$ 1.41
	Trucking		$ 1.00
	Pav't Patch		$ 11.20
			$
			$
			$
	O'head		$
			$ 73.93

62.73

Top made June 4-1952
and old Top disconnected
by Gifford & George

Park St. / ~~Pl.~~ Ave. No. 79

Name of Owner
Bentley

Labor and Mat'l. Report June 4 1952

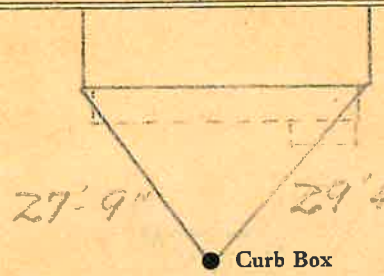

6" Main

Elev. of Main at tap 5 1/2'

Gate at ●

● Gate at

● Curb Box

LSM-5C 10-21-49