LABOR AND MATERIALS

1	Copper Lead — Connection	4 x 6 Tee	$ 12.25
1	Curb — Cock / Valve / ~~T. S. & V.~~	4" in.	$ 22.53
1	Service box — Old returned — Short 3½X4½ / Long 4½X5½ / Buff or Rdway		$ 16.43
3	Ft. 4 in. — Copper / ~~G. I.~~ / C. I.	Pipe at	$ 5.74
	Nipples	in. at	$
	Bushings	to in. at	$
	Red'g Inc'g — Coupl'gs	to in. at	$
	Union	in. at	$
	Meter	in. at	$
1	~~Lead Joints at~~		$ .27
	Compound Joints at	13.165	$ 1.54
1	Hrs. Water Maint. Man—1 at		$ 1.27
	Hrs. Water Maint. Man—2 at		$
	Hrs. Labor— at		$
	Hrs. Labor— at		$
	Hrs. Compressor at		$
	Compensation Ins. at $ per C		$
	Trucking		$
	Pav't Patch		$
	Tap by Keller		$
10'	Mech. Excav. & Laying	40¢	$ 4.—
1 lb.	B.F.	25¢	$ 2.50
	O'head		$ 7.71
			$ 84.98

125

St.
~~Pl.~~ Parker Reserve Ave. No. 2

Name of Owner

U. S. Naval Reserve

Labor and Mat'l. Report Oct 13 19 48

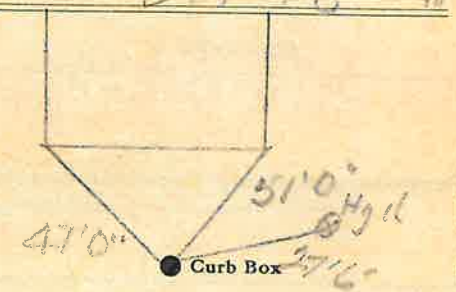

6 Main

Elev. of Main at tap 5'2"

Gate at ● ● Gate at

● Curb Box

4" Tap.

LSM-5C 5 15-48