LABOR AND MATERIALS

1	Copper Lead	Connection 3/4	$ 2 80
1	Curb { Clock Valve T. S. & V. }	3/4 in.	$ 3 60
1	Service box Old returned	{ Short 3½X4½ Long 4½X5½ Buff or Rdway }	$ 5 80
21 19	Ft. 3/4 in.	{ Copper Galv. Iron Cast Iron } Pipe at 35	$ 6 65
	Nipples	in. at	$
	Bushings	to in. at	$
	Red'g Inc'g Couplings	to in. at	$
	Union	in. at	$
	Meter	in. at	$
	Lead Joints at		$
6	Compound Joints at		$
2	Hrs. Foreman at		$ 6 06
2	Hrs. Chauffeur at		$ 1 92
	Hrs. Tapper at		$
40	Hrs. Labor at		$ 34 10
	Hrs. Labor at		$
	Hrs. Compressor at		$
	Compensation Ins.		$ 92
	Trucking		$ 1 —
	Builders Use of Water.		$
Tap by Miller			$
			$
			$
			$
			$ 62 65

77-147

St.
Pl.
Ave. No. 19

Pearl

Name of Owner

Simonetta

Labor and Mat'l. Report July 27? 1947

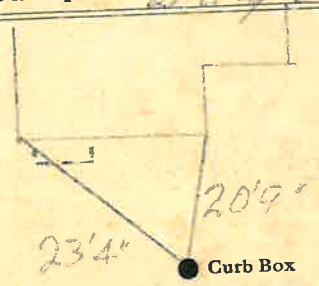

8" C.I. 1968 Main

Elev. of Main at tap 5'-

Gate at

Gate at

Curb Box

TAX ID # 303.17-10-16

LSM-5C-6-1-45