LABOR AND MATERIALS

1	Copper / ~~Lead~~ Connection	3/4	$ 1.23
1	Curb { Cock / ~~Valve~~ / ~~T. S. &~~ V. }	3/4 in.	$ 1.68
1	Service Box Old returned { Short 3½x4½ / Long 4½x5½ / Buff. or Rdway }		$ 1.75
18½	~~17~~ Ft. 3/4 in. { Copper / Galv Iron / Cast Iron } Pipe at 15		$ 2.55
	Nipples ____ in. at		$
	Bushings ____ to ____ in. at		$
	Red'g / Inc'g Couplings ____ to ____ in. at		$
	Union ____ in. at		$
	Meter ____ in. at		$
	Lead Joints at		$
	Leadite Joints at		$
	Hrs. Foreman at		$
6	Hrs. Chauffeur at	62½	$ 3.75
	Hrs. Tapper at		$
10	Hrs. Labor at	45	$ 4.50
	Hrs. Labor at		$
	Hrs. Compressor at		$
	Compensation Ins.	.26	$
	Trucking	1.00	$
	Builders Use of Water	Patch	$ 5.00
Tap by Penn			$
			$
			$
			$
			$ 21.72

9 5 - 1938

St. 2325

~~Pl.~~

Pearl Ave. No. 17-19

Name of Owner

Stewart

Labor and Mat'l. Report Aug 12 19 38

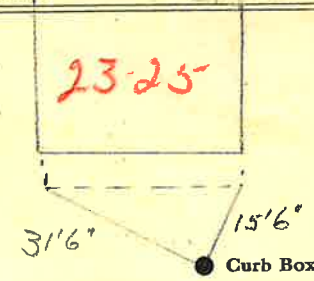

8" C.I. 1968

~~1"~~ Main

Elev. of Main at tap 6

Gate at ● ● Gate at

TAX ID# 303.17-10-14

● Curb Box

old Shut off

66