LABOR AND MATERIALS

1	Copper ~~Lead~~ Connection	3/4"	$ 2.76
1	Curb Cock / Valve / ~~T. S. & V.~~	3/4 in.	$ 3.49
1	Service box Old returned: Short 3½X4½ / ~~Long 4½X5½~~ / ~~Buff or Rdway~~		$ 4.74
12	Ft. 3/4" in. Copper / ~~G. I.~~ / ~~C. I.~~ Pipe at .38		$ 4.56
	Nipples ..... in. at		$
	Bushings ..... to ..... in. at		$
	Red'g Inc'g Coupl'gs ..... to ..... in. at		$
	Union ..... in. at		$
	Meter ..... in. at		$
	Lead Joints at		$
	Compound Joints at		$
	Hrs. Water Maint. Man—1 at		$ 1400
4	Hrs. Water Maint. Man—2 at 1.24		$ 4.96
8	Hrs. Labor— ....at 1.13		$ 9.04
	Hrs. Labor— ....at		$
	Hrs. Compressor at		$
	Compensation Ins. at $4.406 per C		$ .62
	Trucking		$ 1.00
	Pav't Patch		$ 4.05
Tap by Gilcrease 9-8-53			$
			$
			$
	O'head		$
			$ 35.22

31.17

71-53 Lot. 3

St. / ~~Pl.~~ Peck Ave. No. 6

Name of Owner

Charles John

Labor and Mat'l. Report Sept. 8 19 53

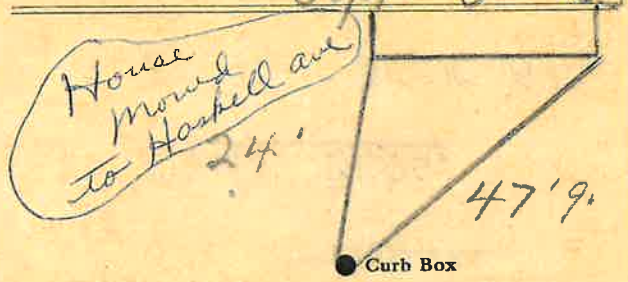

6 Main — Elev. of Main at tap 4½

Gate at ● — ● Gate at

● Curb Box

L6M-5C 5 15-48