LABOR AND MATERIALS

1 Copper / ~~Lead~~ } Connection 3/4 $

1 Curb { Cock / ~~Valve~~ / ~~T. S. & V.~~ } 3/4" in. $

1 Service box { ~~Short 3½ x 4½~~ / Long 4½ x 5½ / ~~Buff or Rdway~~ } $

4' ~~2~~ Ft. 3/4 in. { Copper / G. I. / C. I. } Pipe at $

Nipples in. at $

Bushings to in. at $

Red'g / Inc'g } Coupl'gs to in. at $

Union in. at $

Meter in. at $

Lead Joints at $

Compound Joints at $

Maintenance Foreman $

Hrs. Water Maint. Man—1 at $

Hrs. Water Maint. Man—2 at $

Hrs. Garage Foreman at $

Hrs. Labor— at $

Hrs. Compressor at $

Compensation Ins. at $ per C $

Trucking $

Pav't Patch $

$

Tap July 7, 1978 $

Hook + Co. $

O'head $

$

Philo St. / Pl. / Ave. No. 2

Name of Owner

Adrain Lea

Labor and Mat'l. Report July 7 1978

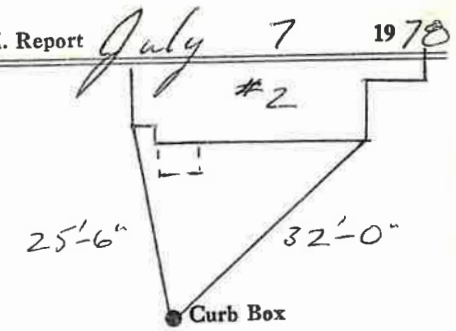

1" Main

Elev. of Main at tap 5'

Gate at

Gate at

Curb Box

TAX ID #302.15-8-1

LSM—5C—6-1-67