LABOR AND MATERIALS

1	Copper ~~Lead~~ Connection 3/4		$ 1.31
1	Curb Cock / Valve / T. S. & V. 3/4 in.		$ 1.75
1	Service Box Old returned Short 3½x4½ / Long 4½x5½ / Buff. or Rdway		$ 1.60
8	Ft. 3/4 in. Copper / Galv Iron / Cast Iron Pipe at 18		$ 1.44
	Nipples in. at		$
	Bushings to in. at		$
	Red'g / Inc'g Couplings to in. at		$
	Union in. at		$
	Meter in. at		$
	Lead Joints at		$
	Leadite Joints at		$
	Hrs. Foreman at		$
2	Hrs. Chauffeur at	62½	$ 1.25
1	Hrs. Tapper at		$ .63
7	Hrs. Labor at	45	$ 3.15
	Hrs. Labor at		$
1	Hrs. Compressor at	.62½	$ .62
	Compensation Ins.		$ .16
	Trucking		$ 1 —
	Builders Use of Water	no Patch	$ —
	Tap by Miller	Before Paving	$
			$
			$
			$
			$ 12.91

8 1 - - 1940

3

St.
~~Pl.~~
Pine Ave. No. 13

Name of Owner
Dr Hull

Labor and Mat'l. Report June 27 19

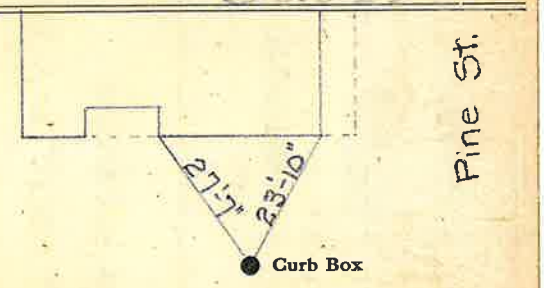

6 Main Elm St. Elev. of Main at tap 6

Gate at ● ● Gate at

● Curb Box

TAX ID# 302.20-22-1