LABOR AND MATERIALS

Copper / Lead } Connection ____ $____

Curb { Cock / Valve / T. S. & V. } ____ in. ____ $____

Service box / Old returned { Short 3½ x 4½ / Long 4½ x 5½ } ____ $____

9 Ft. 3/4 in. { Copper / ~~G. I.~~ / ~~C. I.~~ } Pipe at ____ $____

____ Nipples ____ in. at ____ $____

____ Bushings ____ to ____ in. at ____ $____

Red'g / Inc'g } Coupl'gs ____ to ____ in. at ____ $____

____ Union ____ in. at ____ $____

____ Meter ____ in. at ____ $____

____ ____ $____

____ Compound Joints at ____ $____

____ Maintenance Foreman ____ $____

____ Hrs. Water Maint. Man—1 at ____ $____

____ Hrs. Water Maint. Man—2 at ____ $____

____ Hrs. Garage Foreman ____ at ____ $____

____ Hrs. Labor— ____ at ____ $____

____ Hrs. Compressor at ____ $____

____ $____

____ Trucking ____ $____

____ Pav't Patch ____ $____

____ $____

____ $____

____ $____

____ ____ $____

$____

Pine St. / ~~Pl.~~ / Ave. No. 20

Name of Owner

TAX ID # 309.28-1-22

Labor and Mat'l. Report 19

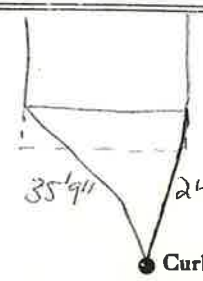

____ Main Elev. of Main at tap ____

Gate at ● ● Gate at

____ ____

● Curb Box

LSM—5C—6-1-67