2 8 - 1939

St.
~~Pl.~~
Ave. No. 7

Pine

Name of Owner

S J Landon

Labor and Mat'l. Report May 19 1939

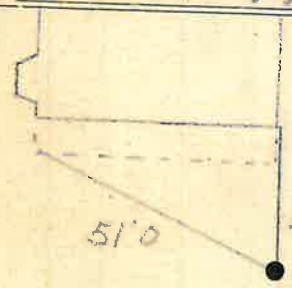

6" Main

Elev. of Main at tap 5'

Gate at

Gate at

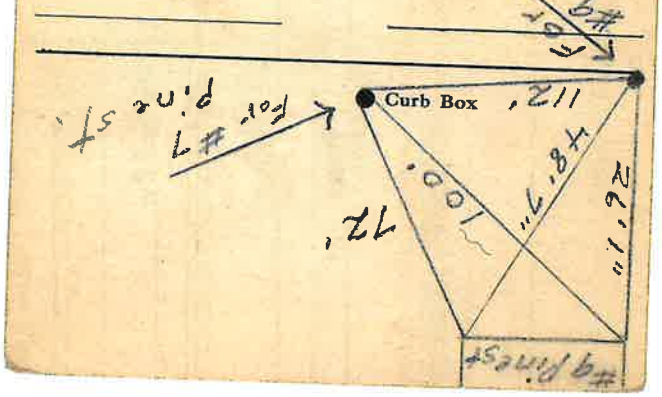

2 8 - 1939

St.
~~Pl.~~
Ave. No. 7

Pine

Name of Owner

S J Landon

Labor and Mat'l. Report May 19 1939

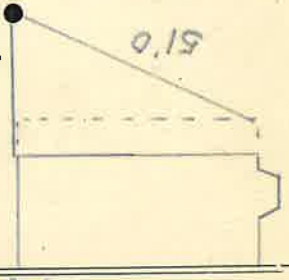

6" Main

Elev. of Main at tap 5'

Gate at

Gate at

For #9

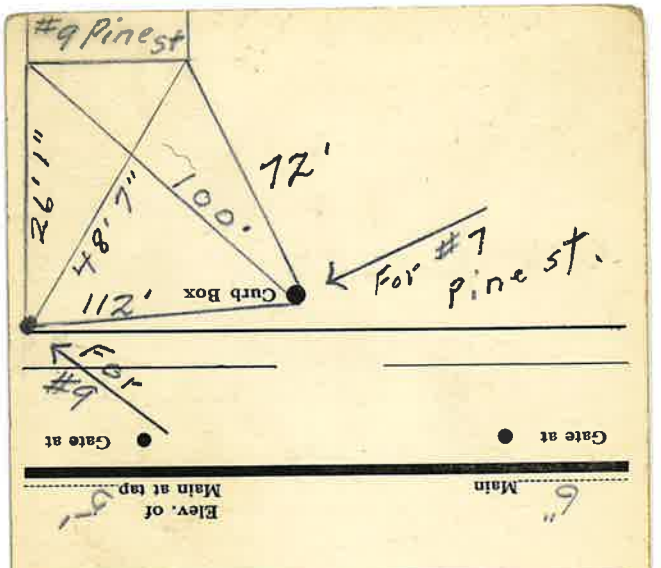

LABOR AND MATERIALS

1	Copper ~~Lead~~ Connection 3/4	$ 1.23
1	Curb Cock ~~Valve~~ ~~T. S. & V.~~ 3/4 in.	$ 1.68
1	Service Box Old returned Short 3½x4½ ~~Long 4½x5½~~ ~~Buff. or Rdway~~	$ 1.54
20	Ft. 3/4 in. Copper ~~Galv Iron~~ ~~Cast Iron~~ Pipe at 17	$ 3.40
1	Nipples 3/4 in. at 4" Long	$ 0.12
	Bushings ____ to ____ in. at	$
1	Red'g Inc'g Couplings 1 1/4 to 3/4 in. at	$ 0.12
	Union ____ in. at	$
	Meter ____ in. at	$
	Lead Joints at	$
	Leadite Joints at	$
	Hrs. Foreman at	$
3	Hrs. Chauffeur at 62½	$ 1.88
5	Hrs. Tapper at —	$ 3.12
6	Hrs. Labor at 45	$ 2.70
	Hrs. Labor at	$
	Hrs. Compressor at	$
	Compensation Ins.	$ .24
	Trucking	$ 1.00
	Builders Use of Water no patch	$ —
	Tapping Hessel	$
		$
		$
		$
		$ 17.03