LABOR AND MATERIALS

1	Copper ~~Lead~~ Connection 3/4	$ 1.23
1	Curb { Cock / Valve / ~~T. S. & V.~~ } 3/4 in.	$ 1.68
1	Service Box Old returned { ~~Short 3½x4½~~ / Long 4½x5½ / ~~Buff. or Rdway~~ }	$ 1.54
7	Ft. 3/4 in. { Copper / ~~Galv Iron~~ / ~~Cast Iron~~ } Pipe at 17	$ 1.19
	Nipples ____ in. at	$
	Bushings ____ to ____ in. at	$
	Red'g / Inc'g Couplings ____ to ____ in. at	$
	Union ____ in. at	$
	Meter ____ in. at	$
	Lead Joints at	$
	Leadite Joints at	$
	Hrs. Foreman at	$
1	Hrs. Chauffeur at 62½	$ .63
4	Hrs. Tapper at "	$ 2.50
9	Hrs. Labor at 45	$ 4.05
	Hrs. Labor at	$
	Hrs. Compressor at	$
	Compensation Ins.	$ .22
	Trucking	$ 1.—
	Builders Use of Water ~~Accepted~~	$
	Teaple Hessel	$
		$
		$
		$
		$ 14.04

2 9 - 1939

St.
~~Pl.~~
Pine Ave. No. 8

Name of Owner

Mrs E W Combs

Labor and Mat'l. Report Nov 19 19 39

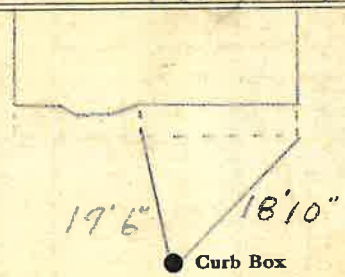

6 Main — Elev. of Main at tap 5'

Gate at ● ● Gate at

TAX ID # 302.20-27-12

● Curb Box

TAX ID # 302.20-27-12

old Shut off to be Chgd