LABOR AND MATERIALS

1	Copper / ~~Lead~~ Connection	3/4	$ 1.35
1	Curb { Cock / ~~Valve~~ / ~~T. S. & V.~~ }	3/4 in.	$ 1.80
1	Service Box / ~~Old returned~~ { Short 3½x4½ / Long 4½x5½ / Buff or Rdway }		$ 1.70
28	Ft. 3/4 in. { Copper / ~~Galv Iron~~ / ~~Cast Iron~~ } Pipe at 18		$ 5.04
	Nipples ..... in. at		$
	Bushings ..... to ..... in. at		$
	Red'g / Inc'g } Couplings ..... to ..... in. at		$
	Union ..... in. at		$
	Meter ..... in. at		$
	Lead Joints at		$
	Leadite Joints at		$
	Hrs. Foreman at		$
3	Hrs. Chauffeur at	62½	$ 1.88
8½	Hrs. Tapper at	"	$ 5.31
12½	Hrs. Labor at	.45	$ 5.63
	Hrs. Labor at		$
3/4	Hrs. Compressor at	62½	$ .46
	Compensation Ins.		$ 39
	Trucking		$ 1 —
	Builders Use of Water	Before Saving	$
	Tap by Hessel		$
			$
			$
			$
			$ 24.56

---

9 7 1941

St. 17
Pl.
Ave. No. 13

Platt

Name of Owner

Lot Tap

Labor and Mat'l. Report Aug 14 1941

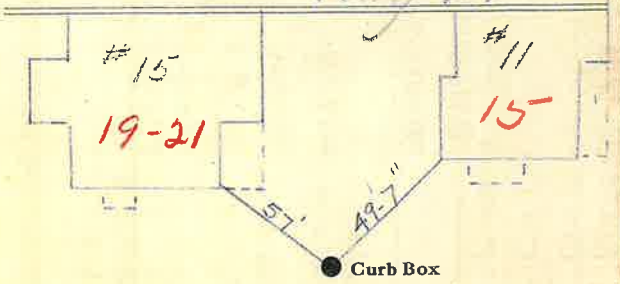

4 Main

Elev. of Main at tap 5

Gate at

Gate at

TAX ID# 303.18-13-7

Curb Box