Labor and Materials

1	Lead Connection 3/4	$
1	Curb Cock 3/4	$
1	Service Box Old returned { ~~Short 3½ x 4½~~ Long 4½ x 5½ ~~Buffalo~~	$
7	Ft. 3/4 in. G. I. Pipe at	$
	Nipples ..... in. at	$
	Bushings ..... to ..... in. at	$
	Red'g Coup .... to .... in. at	$
	Inc'g Coup .... to .... in. at	$
	Union .... in. at	$
	Meter .... in. at	$
	Cu. Yds. Br. Stone at	$
	Cu. Yds. Sand at	$
	Bags Cement at	$
	Paving Brick { Mack Red Asphalt } at	$
	Hrs. Foreman at	$
10	Hrs. Common Labor at	$
	Hrs. Mason at	$
2	Hrs. Pierre at	$
	Hrs. at	$
no	Builders' Use of Water	$
	at	$
	Truck at	$ 1.00
	at	$
	at	$
	Total	$ 11.93

20 July

Labor and Material Report 1 192

16 Platte St.

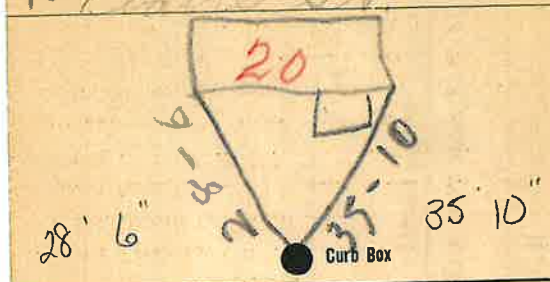

4 Main

Elev. of Main at tap 42

Gate at

Gate at

Curb Box

TAX ID# 303.18-12-6