LABOR AND MATERIALS

1	Copper / ~~Lead~~ Connection	3/4	$ 1.35
1	Curb { Cock / Valve / ~~T. S. & V.~~ }	3/4 in.	$ 1.80
	Service Box Old returned { Short 3⅛x4⅛ / Long 4⅛x5⅛ / Buff or Rdway }	Same	$ —
8	Ft. 3/4 in. { Copper / Galv Iron / Cast Iron }	Pipe at 18	$ 1.44
	Nipples ..... in. at		$
	Bushings ..... to ..... in. at		$
	Red'g / Inc'g } Couplings ..... to ..... in. at		$
	Union ..... in. at		$
	Meter ..... in. at		$
	Lead Joints at		$
	Leadite Joints at		$
	Hrs. Foreman at		$
1	Hrs. Chauffeur at	62½	$ .62
3	Hrs. Tapper at		$ 1.88
4	Hrs. Labor at	45	$ 1.80
	Hrs. Labor at		$
3/4	Hrs. Compressor at	62½	$ .46
	Compensation Ins.		$ .14
	Trucking		$ 1.—
	Builders Use of Water Bit no Saving		$
	Tapping Machine		$
			$
			$
			$
			$ 10.49

9 9 1941

St. 22
~~Pl.~~
~~Ave.~~ No. 18

Platt

Name of Owner City of Glens Falls

Sennett

Labor and Mat'l. Report July 19 9

House razed 1967.

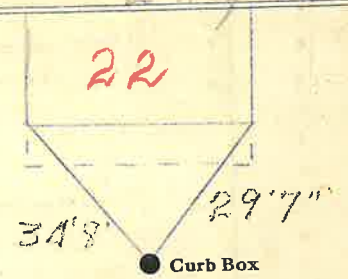

1 Main

Elev. of Main at tap ...

Gate at ● ● Gate at

TAX ID# 303.18-12-7

● Curb Box

Shut off at Curb.

Dec. 3, 1959.