LABOR AND MATERIALS

1	Copper ~~Lead~~ Connection 3/4		$ 1.35
1	Curb Cock ~~Valve~~ ~~T. S. & V.~~ 3/4 in.		$ 1.80
1	Service Box ~~Old returned~~ Short 3½x4½ / Long 4½x5½ / ~~Buff or Rdway~~		$ 1.70
9	Ft. 3/4 in. Copper / Galv Iron / ~~Cast Iron~~ Pipe at 18		$ 1.62
	Nipples in. at		$
	Bushings to in. at		$
	Red'g / Inc'g Couplings to in. at		$
	Union in. at		$
	Meter in. at		$
	Lead Joints at		$
	Leadite Joints at		$
	Hrs. Foreman at		$
1	Hrs. Chauffeur at	62½	$ 62
3	Hrs. Tapper at	"	$ 1.88
4	Hrs. Labor at	45	$ 1.80
	Hrs. Labor at		$
3/4	Hrs. Compressor at	62½	$ .46
	Compensation Ins.		$ 14
	Trucking		$ 1 —
	Builders Use of Water	Before Paving	$ —
	Taply Hosser		$
			$
			$
			$
			$ 12.37

100 1941

St. 24
~~Pl.~~
~~Ave.~~ No. 20

Platt

Name of Owner

Oconnor Hot Tap

Labor and Mat'l. Report Aug 5 1941

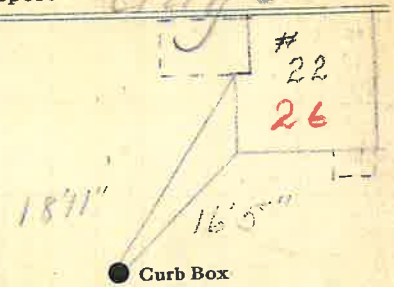

4 Main

Elev. of Main at tap 6

Gate at

Gate at

Curb Box