LABOR AND MATERIALS

1 Copper Lead	Connection 3/4	$ 1.35
1 Curb { Cock Valve T. S. & V. }	3/4 in.	$ 1.80
1 Service Box Old returned	{ Short 3⅛x4⅛ Long 4⅛x5⅛ Buff or Rdway }	$ 1.70
24 Ft. 3/4 in.	{ Copper Galv Iron Cast Iron } Pipe at 18	$ 4.32
Nipples ... in. at		$
Bushings ... to ... in. at		$
Red'g Inc'g } Couplings ... to ... in. at		$
Union ... in. at		$
Meter ... in. at		$
Lead Joints at		$
Leadite Joints at		$
Hrs. Foreman at		$
3 Hrs. Chauffeur at 62½		$ 1.88
8½ Hrs. Tapper at		$ 5.31
12½ Hrs. Labor at 45		$ 5.63
Hrs. Labor at		$
3/4 Hrs. Compressor at .62½		$ .46
Compensation Ins.		$ .39
Trucking		$ 1.—
Builders Use of Water Before Paving		$ —
Tap by Hassel		$
		$
		$
		$
		$ 23.84

9 3 1941

St. ~~Pl.~~ Ave. No. 1 — 3"

Platt

Name of Owner

Mention

Labor and Mat'l. Report July 31 1941

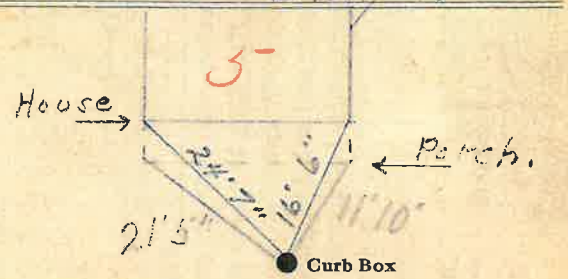

1 Main — Elev. of Main at tap 6

Gate at ● ● Gate at

● Curb Box