LABOR AND MATERIALS

1	Copper ~~Lead~~ Connection	3/4	$ 1.35
1	Curb { Cock ~~Valve T. S. & V.~~ }	3/4 in.	$ 1.80
	Service Box Old returned { Short 3½x4½ Long 4½x5½ Buff or Rdway }	Same	$ —
9	Ft. 3/4 in. { Copper Galv Iron ~~Cast Iron~~ }	Pipe at 18	$ 1.62
	Nipples	in. at	$
	Bushings	to in. at	$
	Red'g Inc'g } Couplings	to in. at	$
	Union	in. at	$
	Meter	in. at	$
	Lead Joints at		$
	Leadite Joints at		$
	Hrs. Foreman at		$
1	Hrs. Chauffeur at	62½	$ .62
3	Hrs. Tapper at		$ 1.88
4	Hrs. Labor at	45	$ 1.80
	Hrs. Labor at		$
3/4	Hrs. Compressor at	62½	$ .46
	Compensation Ins.		$ .14
	Trucking		$ 1.—
	Builders Use of Water	Before Paving	$ —
	Tap by Hesser		$
			$
			$
			$
			$ 10.67

T 03 1941

St. 38
~~Pl.~~
Ave. No. 30

Platt

Name of Owner

LaHaise

Labor and Mat'l. Report July 29 1941

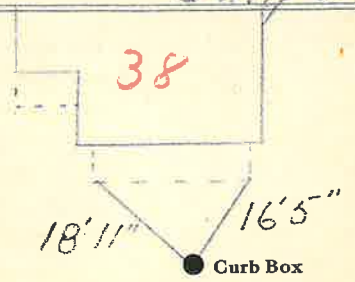

6 Main

Elev. of Main at tap 5—

Gate at ● ● Gate at

TAX ID # 303.18-6-4

● Curb Box