LABOR AND MATERIALS

1	Copper ~~Lead~~ Connection 3/4		$ 1.35
1	Curb Cock ~~Valve~~ ~~T. S. & V.~~ 3/4 in.		$ 1.80
1	Service Box Old returned	Short 3½x4½ ~~Long 4½x5½~~ ~~Buff or Rdway~~	$ 1.70
27	Ft. 3/4 in.	Copper ~~Galv Iron~~ ~~Cast Iron~~ Pipe at 18	$ 4.86
	Nipples in. at		$
	Bushings to in. at		$
	Red'g Inc'g Couplings to in. at		$
	Union in. at		$
	Meter in. at		$
	Lead Joints at		$
	Leadite Joints at		$
	Hrs. Foreman at		$
3	Hrs. Chauffeur at	62½	$ 1.88
8½	Hrs. Tapper at		$ 5.31
12½	Hrs. Labor at	45	$ 5.63
	Hrs. Labor at		$
3/4	Hrs. Compressor at	62½	$ .46
	Compensation Ins.		$ .39
	Trucking		$ 1.4
	Builders Use of Water Before Paving		$
	Tap by Hessel		$
			$
			$
			$
			$ 24.38

1 0 5 1941

St. 39
~~Pl.~~
~~Ave.~~ No. 31B

Platt

Name of Owner

Ben Tim Drury Vachot

Labor and Mat'l. Report Aug 28 1941

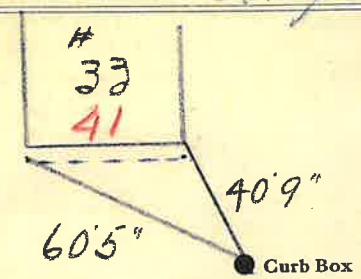

6 Main

Elev. of Main at tap 5

Gate at

Gate at

Curb Box