LABOR AND MATERIALS

Copper / Lead } Connection ..... $.....

Curb { Clock / Valve / T. S. & V. } ..... in. ..... $.....

Service box / Old returned { Short 3½X4½ / Long 4½X5½ / Buff or Rdway } ..... $.....

.....Ft. ..... in. { Copper / Galv. Iron / Cast Iron } Pipe at ..... $.....

.....Nipples ..... in. at ..... $.....

.....Bushings ..... to ..... in. at ..... $.....

Red'g / Inc'g } Couplings ..... to ..... in. at ..... $.....

.....Union ..... in. at ..... $.....

.....Meter ..... in. at ..... $.....

.....Lead Joints at ..... $.....

.....Compound Joints at ..... $.....

.....Hrs. Foreman at ..... $.....

.....Hrs. Chauffeur at ..... $.....

.....Hrs. Tapper at ..... $.....

.....Hrs. Labor at ..... $.....

.....Hrs. Labor at ..... $.....

.....Hrs. Compressor at ..... $.....

.....Compensation Ins. ..... $.....

.....Trucking ..... $.....

.....Builders Use of Water ..... $.....

Water Register ..... $.....

..... $.....

..... $.....

..... $.....

$.....

St. Pl. Ave. 41

Platt No. 33

Name of Owner

Labor and Mat'l. Report June 19[illegible]

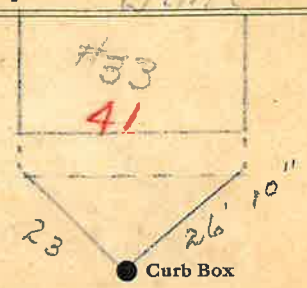

TAX ID# 303.18-7-14

..... Main

Elev. of Main at tap .....

Gate at ●

● Gate at

● Curb Box

LSM-5C-6-1-45