LABOR AND MATERIALS

1	Copper ~~Lead~~ } Connection 3/4		$ 1.35
1	Curb { Cock ~~Valve~~ ~~T. S. & V.~~ } 3/4 in.		$ 1.80
1	Service Box Old returned { Short ~~3½x4½~~ Long 4½x5½ ~~Buff or Rdway~~ }		$ 1.70
8	Ft. 3/4 in. { Copper ~~Galv Iron~~ ~~Cast Iron~~ } Pipe at 18		$ 1.44
	Nipples in. at		$
	Bushings to in. at		$
	Red'g Inc'g } Couplings to in. at		$
	Union in. at		$
	Meter in. at		$
	Lead Joints at		$
	Leadite Joints at		$
	Hrs. Foreman at		$
1	Hrs. Chauffeur at	62½	$ 62
3	Hrs. Tapper at	–	$ 1.88
4	Hrs. Labor at	45	$ 1.80
	Hrs. Labor at		$
3/4	Hrs. Compressor at	62½	$ 46
	Compensation Ins.		$ 14
	Trucking		$ 1.—
	Builders Use of Water	Before Paving	$ —
	Tap by Hessel		$
			$
			$
			$
			$ 12.19

107 1941

St. 46
~~Pl.~~
~~Ave.~~ No. 36

Platt

Name of Owner

Monrian

Labor and Mat'l. Report July 15-1941

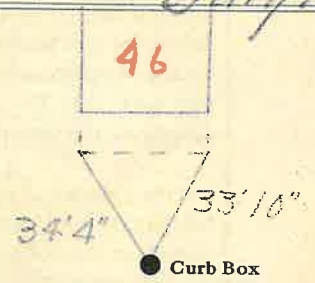

~~6~~ 12" - 1969 Main

Elev. of Main at tap 6

Gate at ● ● Gate at

TAX ID # 303.18-6-7

● Curb Box