LABOR AND MATERIALS

1 Copper ~~Lead~~	Connection 3/4	$ 1.35
1 Curb {Cock ~~Valve~~ ~~T. S. & V.~~}	3/4 in.	$ 1.80
1 Service Box Old returned	{Short 3⅛x4⅛ Long 4⅛x5⅛ Buff or Rdway}	$ 1.70
26 Ft. 3/4 in.	{Copper Galv. Iron Cast Iron} Pipe at 18	$ 4.68
Nipples	in. at	$
Bushings	to in. at	$
Red'g Inc'g	Couplings to in. at	$
Union	in. at	$
Meter	in. at	$
Lead Joints at		$
Leadite Joints at		$
Hrs. Foreman at		$
3 Hrs. Chauffeur at	62½	$ 1.88
8½ Hrs. Tapper at		$ 5.31
12½ Hrs. Labor at	45	$ 5.63
Hrs. Labor at		$
3/4 Hrs. Compressor at	62½	$ 46
Compensation Ins.		$ 39
Trucking		$ 1.-
Builders Use of Water	Before Pouring	$
Taps by Hand		$
		$
		$
		$
		$ 24.20

1 0 9 1941

St. 53
Pl. ~~—~~
Ave. No. 11

Platt

Name of Owner

Toomey

Labor and Mat'l. Report July 29 1941

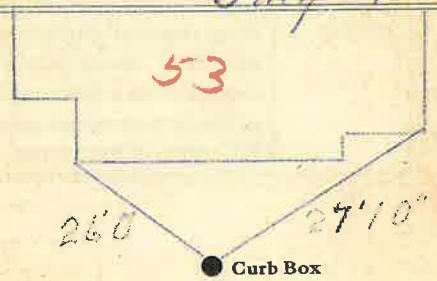

12" - 1962

1 Main

Elev. of Main at tap 5'

Gate at ● ● Gate at

TAX ID # 303.18-2-19

● Curb Box