LABOR AND MATERIALS

1	Copper / Lead } Connection 3/4		$ 1.35
1	Curb { Cock / Valve / T. S. & V. } 3/4 in.		$ 1.80
	Service Box / Old returned { Short 3½x4½ / Long 4½x5½ / Buff or Rdway }	Same	$
25	Ft. 3/4 in. { Copper / Galv Iron / Cast Iron } Pipe at 18		$ 4.50
	Nipples ... in. at		$
	Bushings ... to ... in. at		$
	Red'g / Inc'g } Couplings ... to ... in. at		$
	Union ... in. at		$
	Meter ... in. at		$
	Lead Joints at		$
	Leadite Joints at		$
	Hrs. Foreman at		$
3	Hrs. Chauffeur at	62½	$ 1.88
8½	Hrs. Tapper at	"	$ 5.31
12½	Hrs. Labor at	45	$ 5.63
	Hrs. Labor at		$
3/4	Hrs. Compressor at	62½	$ 46
	Compensation Ins.		$ 39
	Trucking		$ 1 —
	Builders Use of Water Before Paving		$
	Tap by Hosier		$
			$
			$
			$
			$ 22.32

110 1941

Platt St. ~~Pl.~~ ~~Ave.~~ No. 45 57

Name of Owner

Hickey

Labor and Mat'l. Report July 20 1941

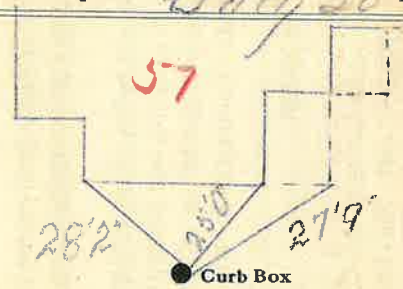

6 Main

Elev. of Main at tap 5

Gate at ● ● Gate at

TAX ID # 303.18-2-17

● Curb Box