Labor and Materials

1	Copper / ~~Lead~~ Connection	3/4	$ 1.46
1	Curb — Cock / ~~Valve~~ / ~~T. S. & V.~~	3/4 in	$ 1.93
1	Service Box Old returned — Short 3½ x 4½ / ~~Long 4½ x 5½~~ / ~~Buff or Rdway~~		$ 1.77
19	Ft. in. — Copper / ~~Galv Iron~~ / Cast Iron Pipe at	3/4	$ 4.18
	Nipples in. at		$
	Bushings to in. at		$
	Red'g / Inc'g Couplings to in. at		$
	Union in. at		$
	Meter in. at		$
	Lead Joints at		$
	Leadite Joints at		$
	Hrs. Foreman at		$
3	Hrs. Chauffeur at .62½		$ 1.88
	Hrs. Tapper at		$
4	Hrs. Labor at .45		$ 1.80
	Hrs. Labor at		$
	Hrs. Compressor at		$
	Compensation Ins.		$ .12
	Trucking		$ 1.00
	Builders Use of Water No Patch - usual		$ —
			$
			$
			$
			$ 14.14

Tap made by me

5 7 1937

St. 63
Pl.
Ave. No. 49

Flat

Name of Owner

Stanwix

Labor and Mat'l. Report Apr 14, 1937

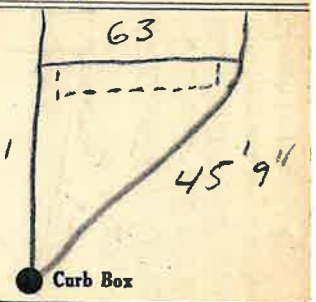

6 Main — Elev. of Main at tap 4'

Gate at • TAX ID # 303.18-2-8 • Gate at

● Curb Box

old Tap Shut off

Charged to Sewer Dept
at W.P.P. See Page