Labor and Materials

Copper / Lead } Connection ..... $

Curb { Cock / Valve / T. S. & V. } ..... in ..... $

Service Box Old returned { Short 3½ x 4½ / Long 4½ x 5½ / Buff. or Rdway } ..... $

.....Ft. .....in. { Copper / Galv Iron / Cast Iron } Pipe at ..... $

Nipples .....in. at ..... $

Bushings .....to .....in. at ..... $

Red'g / Inc'g } Conplings .....to .....in. at ..... $

Union ..... in. at ..... $

Meter .....in. at ..... $

Lead Joints at ..... $

Leadite Joints at ..... $

Hrs. Foreman at ..... $

Hrs, Chauffeur at ..... $

Hrs. Tapper at ..... $

Hrs. Labor at ..... $

Hrs. Labor at ..... $

Hrs. Compressor at ..... $

Compensation Ins. ..... $

Trucking ..... $

Builders Use of Water ..... $

..... $

..... $

..... $

..... $

$

Platt St. ~~Pl.~~ ~~Ave.~~ 90 ~~E~~ No. 64

Name of Owner

Labor and Mat'l. Report 19

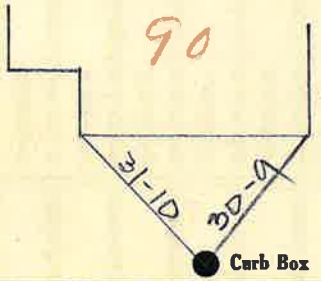

.....Main Elev. of Main at tap..... .....

Gate at • • Gate at

• Curb Box

TAX ID# 303.14-2-4