LABOR AND MATERIALS

1	Copper Lead — Connection	3/4	$ 2.80
1	Curb — Clock / Valve / T. S. & V.	3/4 in.	$ 3.60
1	Service box — Old returned — Short 3½X4½ / Long 4½X5½ / Buff or Rdway		$ 5.80
13 Ft. 3/4 in.	Copper / Galv. Iron / Cast Iron	Pipe at 35	$ 4.55
	Nipples	in. at	$
	Bushings	to in. at	$
	Red'g / Inc'g Couplings	to in. at	$
	Union	in. at	$
	Meter	in. at	$
	Lead Joints at		$
	Compound Joints at		$
	Hrs. Foreman at		$
1	Hrs. Chauffeur at		$ 91
4	Hrs. Tapper at	91	$ 3.64
14	Hrs. Labor at	80	$ 1.20
	Hrs. Labor at		$
1	Hrs. Compressor at		$ .88
	Compensation Ins.		$ .35
	Trucking		$ +—
	Builders Use of Water		$ 5.80
Tap & Mcguinn			$
			$
			$
			$
			$ 40.53

128-47

Platt St. / Pl. / Ave. No. 97

Name of Owner

Putman

Labor and Mat'l. Report Oct 8 1947

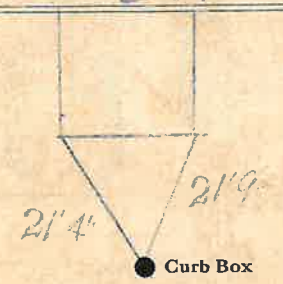

1 Main

Elev. of Main at tap 5

Gate at ● ● Gate at

TAX ID#

● Curb Box

LSM-5C-6-1-45