## LABOR AND MATERIALS

| | | | |
|---|---|---|---|
| 1 | Copper ~~Lead~~ Connection 3/4 | | $ 1.78 |
| 1 | Curb Clock ~~Valve~~ ~~T. S. & V.~~ 3/4 in. | | $ 2.61 |
| | Service box Old returned Short 3½X4½ Long 4½X5½ Buff or Rdway | Same Box | $ — |
| 25 | Ft. 3/4 in. Copper ~~Galv. Iron~~ ~~Cast Iron~~ Pipe at 23 | | $ 5.75 |
| | Nipples in. at | | $ |
| | Bushings to in. at | | $ |
| | Red'g Inc'g Couplings to in. at | | $ |
| | Union in. at | | $ |
| | Meter in. at | | $ |
| | Lead Joints at | | $ |
| | Compound Joints at | | $ |
| | Hrs. Foreman at | | $ |
| 4 | Hrs. Chauffeur at | 75 | $ 3.00 |
| 8 | Hrs. Tapper at | 75 | $ 6.00 |
| 23 | Hrs. Labor at | 65 | $ 14.95 |
| | Hrs. Labor at | | $ |
| 2 | Hrs. Compressor at | 87½ | $ 1.75 |
| | Compensation Ins. | | $ .66 |
| | Trucking | | $ 1.00 |
| | Builders Use of Water | ? | $ 5.00 |
| | Tap by Maguire | | $ |
| | | | $ |
| | | | $ |
| | | | $ |
| | | | $ 42.50 |

✓

37-46 ✓

Platt St

St. ~~Pl.~~ ~~Ave.~~ No. ~~80~~ 108

Name of Owner

Putney

Labor and Mat'l. Report June 20 1946

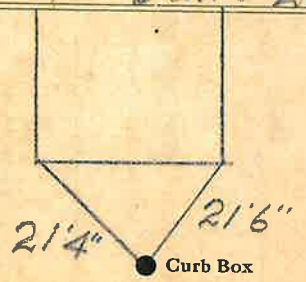


6 Main

Elev. of Main at tap 4

Gate at ● ● Gate at

TAX ID# 303.14-2-10

● Curb Box

LSM-5C-6-1-45