Labor and Materials

1	Copper Lead — Connection	3/4"	$ 2.71
1	Curb — Cock / ~~Valve~~ / ~~T. S. & V.~~	3/4 in	$ 3.83
Same	Service Box — ~~Old returned~~ — Short 3½ x 4½ / Long 4½ x 5½ / Buff. or Rdway		$ —
25 3/4	Ft. ... in. — Copper / Galv Iron / Cast Iron — Pipe at 45		$ 11.25
	Nipples ... in. at		$
	Bushings ... to ... in. at		$
	Red'g / Inc'g Couplings ... to ... in. at		$
	Union ... in. at		$
	Meter ... in. at		$
	Lead Joints at		$ 10.12
	Leadite Joints at		$
	Hrs. Foreman at		$
13	Hrs. Chauffeur at m.m.2 124		$ 16.12
	Hrs. Tapper at		$
25	Hrs. Labor at 113		$ 29.38
	Hrs. Labor at		$
	Hrs. Compressor at		$
	Compensation Ins. 4.29		$ 1.95
	Trucking		$ 1.50
	Builders Use of Water		$ 19.80
Tap by Gigsgould	7-26-53		$
			$
			$
			$ 86.54

St. ~~Pl.~~ Ave. 116

Platt

Name of Owner Scarselletta

Labor and Mat'l. Report July 26 1953

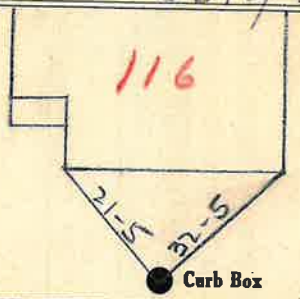

6" Main — Elev. of Main at tap 4'

Gate at • • Gate at

TAX ID # 303.14-2-12.1

● Curb Box

ON When ON OFF Position