LABOR AND MATERIALS

1	Copper / ~~Lead~~ Connection 3/4	$ 2.94
1	Curb Cock / ~~Valve~~ / ~~T. S. & V.~~ 3/4 in.	$ 3.71
1	Service box Old returned Short ~~3½X4½~~ / Long 4½X5½ / ~~Buff or Rdway~~	$ 5.90
27	Ft. 3/4 in. Copper / ~~C. I.~~ / ~~C. I.~~ Pipe at 30	$ 8.10
	Nipples ..... in. at	$
	Bushings ..... to ..... in. at	$
	Red'g / Inc'g Coupl'gs ..... to ..... in. at	$
	Union ..... in. at	$
	Meter ..... in. at	$
	Lead Joints at	$
	Compound Joints at	$
10	Hrs. Water Maint. Man—1 at 1.12	$ 11.20
10	Hrs. Water Maint. Man—2 at 1.02	$ 10.20
22	Hrs. Labor— ..... at 91	$ 20.02
	Hrs. Labor— ..... at	$
2	Hrs. Compressor at	$
	Compensation Ins. at $ ..... per C	$ 91
	Trucking	$ 1.00
	Pav't Patch	$ —
	Tap by Mag	$
		$
		$
	O'head	$
		$ 63.98

140

Prospect St. / Pl. / Ave. No. 55

Name of Owner

Keefe

Labor and Mat'l. Report Oct 1 1948

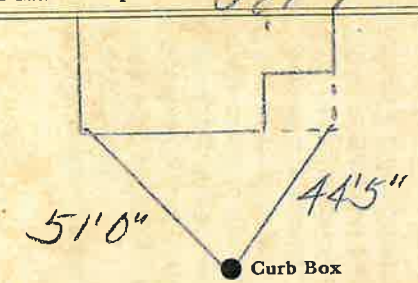

6 Main

Elev. of Main at tap 5

Gate at ● ● Gate at

TAX ID# 303.17-6-14

● Curb Box

3/4" copper
27' to main

LSM-5C 5 15-48