LABOR AND MATERIALS

1	Copper ~~Lead~~ Connection 3/4	$ 2.80
1	Curb {Clock ~~Valve~~ ~~T. S. & V.~~} 3/4 in.	$ 3.60
1	Service box Old returned {Short 3½X4½ ~~Long 4½X5½~~ Buff or Rdway}	$ 5.80
14	Ft. 3/4 in. {Copper ~~Galv. Iron~~ ~~Cast Iron~~} Pipe at 35	$ 4.90
	Nipples in. at	$
	Bushings to in. at	$
	Red'g Inc'g Couplings to in. at	$
	Union in. at	$
	Meter in. at	$
	Lead Joints at	$
	Compound Joints at	$
1	Hrs. ~~Foreman at~~ WWM - 92½	$ 93
9	Hrs. Chauffeur at 82½	$ 742.50
2	Hrs. Tapper at 82½	$ 165.00
14	Hrs. Labor at 71½	$ 10.01
	Hrs. Labor at	$
	Hrs. Compressor at	$
	Compensation Ins.	$ .44
	Trucking	$ 1.—
	Builders Use of Water	$ 4.70
	Tap by Warsinski	$
		$
		$
		$
		$ 43.25

29.47

Prospect St. ~~Pl.~~ Ave. No. 58

Name of Owner

Del Signore

Labor and Mat'l. Report May 24 1947

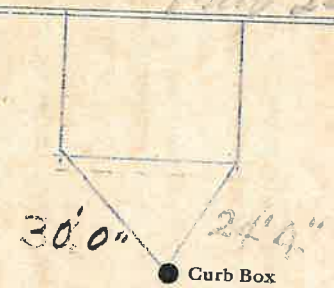

6 Main

Elev. of Main at tap 5

Gate at

Gate at

TAX ID# 303.17-5-6

Curb Box

3/4" Copper
14' to MAIN

LSM-5C-6-1-45