LABOR AND MATERIALS

1	Copper / Lead — Connection	3/4	$ 2.29
1	Curb — Cock / Valve / T.S. & V.	3/4 in.	$ 2.70
1	Service box — Old returned — Short 3½x4½ / Long 4½x5½ / Buff or Rdway		$ 4.25
29	Ft. 3/4 in. — Copper / G.I. / C.I. — Pipe at 35		$ 10.15
	Nipples in. at		$
	Bushings to in. at		$
	Red'g / Inc'g — Coupl'gs to in. at		$
	Union in. at		$
	Meter in. at		$
	Lead Joints at		$
	Compound Joints at		$
4	Hrs. Water Maint. Man—1 at	1.12	$ 4.48
8	Hrs. Water Maint. Man—2 at	1.02	$ 8.16
14	Hrs. Labor— at	91	$ 12.74
	Hrs. Labor— at		$
2	Hrs. Compressor at	1.20	$ 2.40
	Compensation Ins. at $ per C.		$ .56
	Trucking		$ 1.—
	Pav't Patch		$ 15.75
	Top 4 miles		$
			$
			$
	O'head		$
			$ 64.48

St. Pl. Ave. No. 57 Prospect St

Name of Owner

Corata

Labor and Mat'l. Report Oct 12 19 50

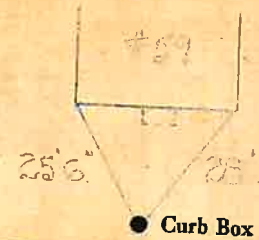

● Curb Box

6 Main — Elev. of Main at tap

Gate at ● — ● Gate at

TAX ID # 303.17-6-12

● Curb Box

3/4" Copper
29' to MAIN

LSM-SC 10-21-49