LABOR AND MATERIALS

1 Copper ~~Lead~~ Connection 3/4		$ 2.87
1 Curb Cock ~~Valve~~ ~~T. S. & V.~~ 3/4 in.		$ 3.62
1 Service box ~~Old returned~~ Short 3½X4½ Long 4½X5½ ~~Buff or Rdway~~		$ 4.68
37 Ft. 3/4 in. Copper ~~G. I.~~ ~~C. I.~~ Pipe at 37		$ 11.84
Nipples in. at		$
Bushings to in. at		$
Red'g Inc'g Coupl'gs to in. at		$
Union in. at		$
Meter in. at		$
Lead Joints at		$
Compound Joints at		$
13 Hrs. Water Maint. Man—1 at	1.12	$ 14.56
Hrs. Water Maint. Man—2 at		$
28 Hrs. Labor— at	.91	$ 25.48
Hrs. Labor— at		$
Hrs. Compressor at		$
Compensation Ins. at $ per C		$ .87
Trucking		$ 2.00
Pav't Patch		$ 14.85
Tap by Miller		$
		$
		$
O'head		$
		$ 80.77

9

Prospect St. ~~Pl.~~ ~~Ave.~~ No. 73

Name of Owner

Polunci

Labor and Mat'l. Report Apr 13 19 49

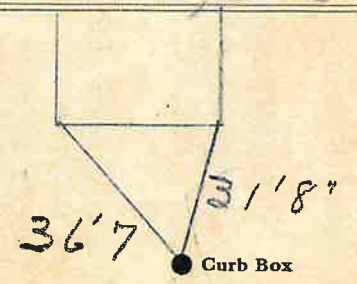

6" Main

Elev. of Main at tap 5'

Gate at ● ● Gate at

37' to MAIN

● Curb Box

3/4" Copper

TAX ID# 303.13-21-22

LSM-5C 5 15-48