LABOR AND MATERIALS

1	Copper ~~Lead~~ Connection	3/4	$ 1.80
1	Curb { Cock ~~Valve~~ ~~T. S. & V.~~ }	3/4 in.	$ 1.96
1	Service Box ~~Old returned~~ { Short 3½x4½ ~~Long 4½x5½~~ Buff or Rdway }		$ 1.82
33	Ft. 3/4 in. { Copper Galv Iron Cast Iron } Pipe at		$ 6.27
	Nipples ..... in. at		$
	Bushings ..... to ..... in. at		$
	Red'g Inc'g } Couplings ..... to ..... in. at		$
	Union ..... in. at		$
	Meter ..... in. at		$
	Lead Joints at		$
	Leadite Joints at		$
	Hrs. Foreman at		$
18	Hrs. Chauffeur at 69¾		$ 12.38½
	Hrs. Tapper at		$
17	Hrs. Labor at .60		$ 10.20
	Hrs. Labor at		$
2	Hrs. Compressor at .87½		$ 1.75
	Compensation Ins. 2.66¢		$ .60
	Trucking		$ .10
	Builders Use of Water		$ 16.38
	Tap by Warsinske		$
			$
			$
			$
			$ 54.16

5/44

St. ~~Pl.~~ ~~Ave.~~ Prospect No. 65 (81)

Name of Owner

Funicello Lot tap

Labor and Mat'l. Report May 24 1944

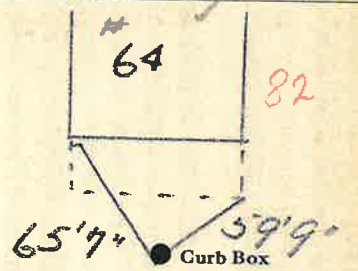

Measure from 64 across Street 82

6 Main

Elev. of Main at tap 5

Gate at ● ● Gate at

● Curb Box

3/4" copper
33' to main