Labor and Materials

1	Copper ~~Lead~~ Connection	3/4	$ 1.46
1	Curb Cock ~~Valve~~ ~~T. S. & V.~~	3/4 in	$ 1.93
1	Service Box Old returned Short 3½ x 4½ ~~Long 4½ x 6½~~ ~~Buff. or Rdway~~		$ 1.77
28 Ft.	3/4 in. Copper ~~Galv. Iron~~ ~~Cast Iron~~ Pipe at	3/4	$ 6.16
	Nipples in. at		$
	Bushings to in. at		$
	Red'g Inc'g Couplings to in. at		$
	Union in. at		$
	Meter in. at		$
	Lead Joints at		$
	Leadite Joints at		$
	Hrs. Foreman at		$
7	Hrs. Chauffeur at		$ 4.38
	Hrs. Tapper at		$
30	Hrs. Labor at .45		$ 13.50
	Hrs. Labor at		$
	Hrs. Compressor at		$
	Compensation Ins.		$ .55
	Trucking		$ 1.00
	Builders Use of Water No patch Hardum		$
			$
			$
	Tap made by Person		$
			$ 30.75

3 2 - 1937

St. Pl. Ave. 33 Product No. 27

Name of Owner

Owner

Labor and Mat'l. Report June 22 1937

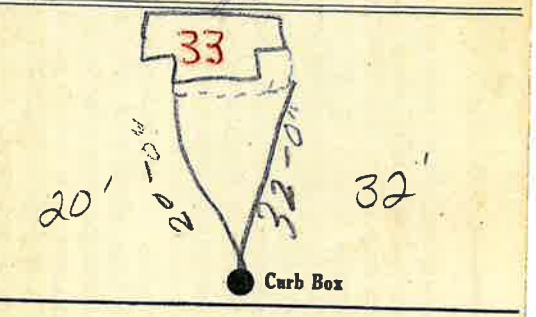

4 Main

Elev. of Main at tap 5

Gate at • TAX ID# 303.17-15-12 • Gate at

● Curb Box

Old tap sheet off to main

Renewal Tap - 1996

3/4" Copper 28' to MAIN