LABOR AND MATERIALS

1	Copper ~~Lead~~ Connection	3/4	$ 2.94
1	Curb { Clock Valve ~~T. S. & V.~~ }	3/4 in.	$ 3.71
1	Service box Old returned { Short 3½X4½ ~~Long 4½X5½~~ Buff or Rdway }		$ 5.90
23	Ft. 3/4 in. { Copper Galv. Iron Cast Iron } Pipe at 30		$ 6.90
	Nipples in. at		$
	Bushings to in. at		$
	Red'g Inc'g } Couplings to in. at		$
	Union in. at		$
	Meter in. at		$
	Lead Joints at		$
	Compound Joints at		$
	Hrs. Foreman at		$
4	Hrs. ~~Chauffeur at~~ W.M.M.-2	91	$ 3.64
	Hrs. Tapper at		$
8	Hrs. Labor at	80	$ 6.40
	Hrs. Labor at		$
	Hrs. Compressor at		$
	Compensation Ins.		$ .22
	Trucking		$ 1.00
	Builders Use of Water Patch		$
	Tap & Plug		$
			$
			$
			$
			$ 30.71

19

Goodman St. ~~Pl.~~ 41 Ave. No. 2

Name of Owner

Happy

Labor and Mat'l. Report Sept 30 1948

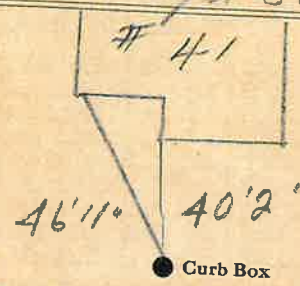

6 Main Elev. of Main at tap 4

Gate at ● ● Gate at

TAX 10TH 302.19-15-22

● Curb Box

3/4" copper
23' to main

LSM-5C-6-1-45