LABOR AND MATERIALS

1	Copper ~~Lead~~ Connection	3/4	$ 2.80
1	Curb { ~~Clock~~ ~~Valve~~ ~~T. S. & V.~~ }	3/4 in.	$ 3.60
1	Service box ~~Old returned~~ { Short 3½X4½ Long 4½X5½ ~~Buff or Rdway~~ }		$ 5.80
21	Ft. 3/4 in. { Copper ~~Galv. Iron~~ ~~Cast Iron~~ }	Pipe at 35	$ 8.40
	Nipples	in. at	$
	Bushings	to in. at	$
	Red'g Inc'g Couplings	to in. at	$
	Union	in. at	$
	Meter	in. at	$
	Lead Joints at		$
	Compound Joints at		$
	Hrs. Foreman at		$
	Hrs. Chauffeur at		$
1	Hrs. Tapper at	91	$ 91
7	Hrs. Labor at	80	$ 5.60
	Hrs. Labor at		$
	Hrs. Compressor at		$
	Compensation Ins.		$ 1.14
	Trucking		$ 1.00
	Builders Use of Water		$ 5.80
	Tap by [illegible]		$
			$
			$
			$
			$ 34.05

14-47

Guade ~~St.~~ 43
Goodman ~~Pl.~~ Ave. No. 7

Name of Owner

Gowan

Labor and Mat'l. Report Oct 21 19 47

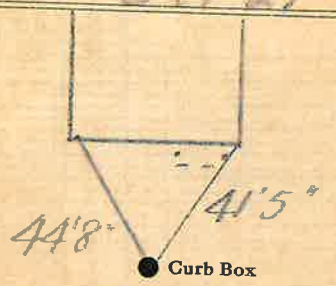

6 Main — Elev. of Main at tap 4

Gate at ● ● Gate at

TAX ID# 302.19-15-21

● Curb Box

3/4" copper
24' to MAIN

LSM-5C-6-1-48