LABOR AND MATERIALS

1 Copper ~~Lead~~ } Connection 3/4" ..... $ .....

1 Curb { Cock ~~Valve~~ ~~T.C. & V.~~ } 3/4 in. ..... $ .....

1 Service box { Short 3½ x 4½ ~~Long 4½ x 6½~~ ~~Ruff or Rdway~~ } ..... $ .....
~~Old returned~~

7 Ft 3/4 in. { Copper ~~Lead~~ ~~Gal.~~ } Pipe at ..... $ .....

..... Nipples ..... in. at ..... $ .....

..... Bushings ..... to ..... in. at ..... $ .....

..... Red'g / Inc'g } Coupl'gs ..... to ..... in. at ..... $ .....

..... Union ..... in. at ..... $ .....

..... Meter ..... in. at ..... $ .....

..... Lead Joints at ..... $ .....

..... Compound Joints at ..... $ .....

..... Maintenance Foreman ..... $ .....

..... Hrs. Water Maint. Man—1 at ..... $ .....

..... Hrs. Water Maint. Man—2 at ..... $ .....

..... Hrs. Garage Foreman ..... at ..... $ .....

..... Hrs. Labor— ..... at ..... $ .....

..... Hrs. Compressor at ..... $ .....

..... Compensation Ins. at $ ..... per C ..... $ .....

..... Trucking ..... $ .....

..... Pav't Patch ..... $ .....

..... MARCH-15-1974 ..... $ .....

..... $ .....

..... O'head ..... $ .....

..... $ .....

Replaced old Copper Service Main to Curb Box
3-15-1974

St. Pl. Ave. No. Raymond 15

Name of Owner

Wm. Gubitz

Measured in

Labor and Mat'l. Report July 30 1954

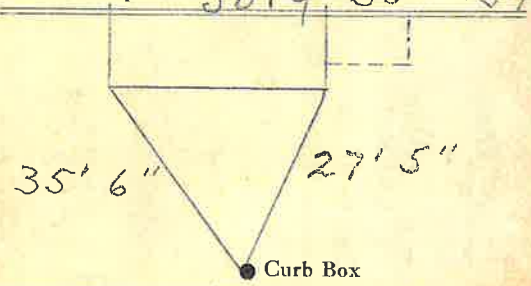

4" Main Elev. of Main at tap 4½'

Gate at • • Gate at

TAX ID # 303.9-10-6

• Curb Box

3/4" Copper
7' to MAIN

LSM—5C—2-1-54