LABOR AND MATERIALS

_____ Copper / Lead } Connection _____ $ _____

_____ Curb } Cock / Valve / T.S. & V. } _____ in. _____ $ _____

_____ Service box / Old returned { Short 3-1/2 x 4-1/2 / Long 4-1/2 x 5-1/2 } _____ $ _____

_____ Ft. _____ in. { Copper / G.I. / C.I. } Pipe at _____ $ _____

_____ Nipples _____ in. at _____ $ _____

_____ Bushings _____ to _____ in. at _____ $ _____

_____ Red'g

_____ Inc'g

_____ Union _____ in. at _____ $ _____

_____ Meter _____ in. at _____ $ _____

_____ _____ $ _____

_____ Compound Joints at _____ $ _____

_____ Maintenance Foreman _____ $ _____

_____ Hrs. Water Maint. Man - 1 at _____ $ _____

_____ Hrs. Water Maint. Man - 2 at _____ $ _____

_____ Hrs. Garage Foreman _____ at _____ $ _____

_____ Hrs. Labor _____ at _____ $ _____

_____ Hrs. Compressor at _____ $ _____

_____ _____ $ _____

_____ Trucking _____ $ _____

_____ Pav't Patch _____ $ _____

_____ _____ $ _____

_____ _____ $ _____

_____ _____ $ _____

_____ _____ $ _____

$ _____

20 RIDGE St. / Pl. / Ave. No. _____

Name of Owner

Labor and Mat'l. Report 19

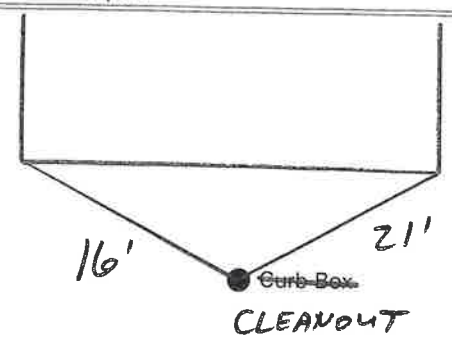

_____ Main

Elev. of Main at tap _____

Gate at ●

● Gate at

_____ _____

● Curb Box

RECEIVED
JAN 15 2018
City of Glens Falls
W.W.T.P.