Labor and Materials

1	Copper ~~Lead~~ Connection	3/4	$ 1.23
1	Curb Cock / ~~Valve~~ / ~~T. S. & V.~~	3/4 in	$ 1.68
1	Service Box Old returned ~~Short 3½ x 4½~~ / Long 4½ x 5½ / ~~Buff or Rdway~~	3/4	$ 1.75
9	Ft. ..... in. Copper / ~~Galv. Iron~~ / ~~Cast Iron~~ Pipe at	3/4	$ 1.20
	Nipples ..... in. at		$
	Bushings ..... to ..... in. at		$
	Red'g / Inc'g Couplings ..... to ..... in. at		$
	Union ..... in. at		$
	Meter ..... in. at		$
	Lead Joints at		$
	Leadite Joints at		$
	Hrs. Foreman at		$
13/5	Hrs. Chauffeur at 62½		$ 8.12
	Hrs. Tapper at -		$ 3.13
8	Hrs. Labor at 45		$ 3.60
	Hrs. Labor at		$
	Hrs. Compressor at		$
	Compensation Ins.		$ .46
	Trucking		$ 1.00
	Builders Use of Water Patch		$ 3.00
	Tap by Hassell		$
			$
			$
			$
			$ 27.17

8 2 - 1938 311

St. / ~~Pl.~~ / ~~Ave.~~ Ridge No. 255

Name of Owner

Joseph P Kelly

Labor and Mat'l. Report July 2, 1938

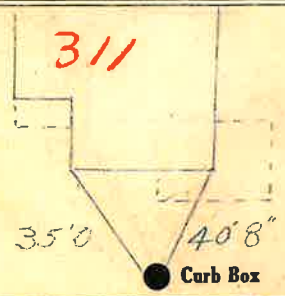

TAX ID # 303.9-7-19

1 Main Elev. of Main at tap 6

Gate at • • Gate at

● Curb Box

NEW CURB BOX INSTALLED 1 FT CLOSER TO MAIN. 7/15/2009

3/4" - 8' COPPER

to be billed