LABOR AND MATERIALS

1	Copper / ~~Lead~~ Connection	3/4"	$ 2.71
1	Curb { Cock / ~~Valve~~ / ~~T. S. & V.~~ }	3/4 in.	$ 3.83
1	Service box Old returned { Short 3½ x 4½ / ~~Long 4½ x 5½~~ / ~~Buff or Rdway~~ }		$ 469
16	Ft. 3/4 in. { Copper / ~~G. I.~~ / ~~G. I.~~ } Pipe at	45	$ 7.20
	Nipples in. at		$
	Bushings to in. at		$
	Red'g / Inc'g Coupl'gs to in. at		$
	Union in. at		$
	Meter in. at		$
	Lead Joints at		$ 1.80
	Compound Joints at		$
	Maintenance Foreman		$
	Hrs. Water Maint. Man—1 at		$
13	Hrs. Water Maint. Man—2 at	1.24	$ 16.12
	Hrs. Garage Foreman at		$
21	Hrs. Labor— at	1.13	$ 23.73
	Hrs. Compressor at		$
	Compensation Ins. at $ 4.29 per C		$ 1.71
	Trucking		$ 1.50
	Pay't Patch		$ 15.68
Tap by Gifford 11-17-55			$
			$
			$
	O'head		$
			$ 77.14

St. ~~Pl.~~ ~~Ave.~~ No. 153

Ridge

Name of Owner

Singleton,

Labor and Mat'l. Report Nov. 17 1955

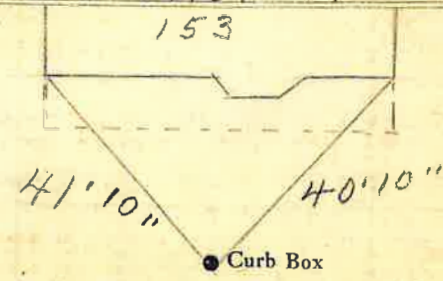

6" Main

Elev. of Main at tap 5'

Gate at •

• Gate at

• Curb Box

3/4" COPPER
16' TO MAIN

L M—5C—2-1-54

TAX ID # 303.17-1-21