211 RIDGE. St Pl. Ave. No. _____

Name of Owner

TAX ID # 303.13-1-27

Labor and Mat'l. Report 19

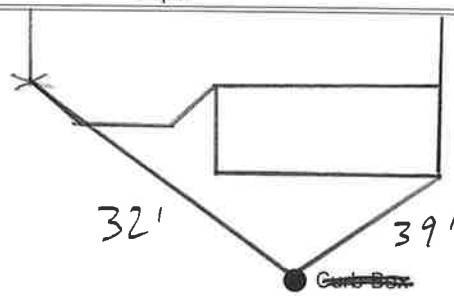

CLEANOUT

_____ Main

Elev. of Main at tap _____

Gate at ●

● Gate at

● Curb Box

RECEIVED
JAN 15 2018
City of Glens Falls
W.W.T.P.

30-152 211 Nov. 12 1930

Labor and Material Report

163 Ridge St

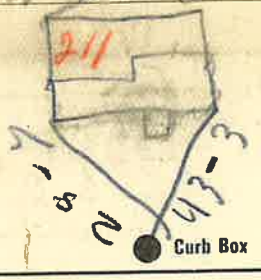

6 Main

Elev. of Main at tap 4½

Gate at ●

● Gate at

● Curb Box

Old Tap disconnected

3/4" - 16' copper

LABOR AND MATERIALS

_____ Copper / Lead } Connection _____ $ _____

_____ Curb { Cock / Valve / T.S. & V. } _____ in. _____ $ _____

_____ Service box / Old returned { Short 3-1/2 x 4-1/2 / Long 4-1/2 x 5-1/2 } _____ $ _____

_____ Ft. _____ in. { Copper / G.I. / C.I. } Pipe at _____ $ _____

_____ Nipples _____ in. at _____ $ _____

_____ Bushings _____ to _____ in. at _____ $ _____

_____ Red'g

_____ Inc'g

_____ Union _____ in. at _____ $ _____

_____ Meter _____ in. at _____ $ _____

_____ _____ $ _____

_____ Compound Joints at _____ $ _____

_____ Maintenance Foreman _____ $ _____

_____ Hrs. Water Maint. Man - 1 at _____ $ _____

_____ Hrs. Water Maint. Man - 2 at _____ $ _____

_____ Hrs. Garage Foreman _____ at _____ $ _____

_____ Hrs. Labor _____ at _____ $ _____

_____ Hrs. Compressor at _____ $ _____

_____ _____ $ _____

_____ Trucking _____ $ _____

_____ Pav't Patch _____ $ _____

_____ _____ $ _____

_____ _____ $ _____

_____ _____ $ _____

_____ _____ $ _____

$ _____

Labor and Materials

1 Copper / ~~Lead~~ } Connection ..... 3/4 ..... $ 2.70

1 Curb { Cock / ~~Valve~~ / ~~T. S. & V.~~ } ..... in. ..... 3/4 ..... $ 2.39

1 Service Box / Old returned { ~~Short 3½x4½~~ / Long 4½x5½ / ~~Buff. or Rdwy~~ } ..... $ 1.55

16 Ft. ..... in. { Copper / ~~Galv. Iron~~ / ~~Cast Iron~~ } Pipe at ..... 3/4 ..... $ 4.32

Nipples ..... in. at ..... 3/4 ..... $

Bushings ..... to ..... in. at ..... $

Red'g / Inc'g } Couplings ..... to ..... in. at ..... $

Union ..... in. at ..... $

Meter ..... in. at ..... $

Lbs. Br. Stone at ..... $

Lbs. Sand at ..... $

Bags Cement at ..... $

Paving Brick { Mack / Red / Asphalt } at ..... $

Lead Joints at ..... $

Leadite Joints at ..... $

3 Hrs. Foreman at ..... $ 1.88

6 Hrs ~~Common Labor~~ at Tapper @ 50 $ 3.—

6 Hrs. Common Labor at @ 45 $ 2.70

Hrs Mason at ..... $

Hrs Mason's Helper at ..... $

1 Hrs. Compressor at ..... $ 1.50

Compensation Ins ..... $ .23

Trucking ..... $ 1.—

Builders' Use of Water Patch ..... $ .23—

Total $ 14.27