Labor and Materials

¾ Copper ~~Lead~~	Connection 3/4	$ 1.46
¾ Curb	Cock ~~Valve~~ T. S. & V. in 3/4	$ 1.93
1 Service Box ~~Old returned~~	Short 3½ x 4½ ~~Long 4½ x 5½~~ Buff. or Rdway	$ 1.77
28 Ft. ... in.	Copper ~~Galv Iron~~ ~~Cast Iron~~ Pipe at 3/4	$ 6.16
Nipples ... in. at		$
Bushings ... to ... in. at		$
Red'g Inc'g Coplings ... to ... in. at		$
Union ... in. at		$
Meter ... in. at		$
Lead Joints at		$
Leadite Joints at		$
Hrs. Foreman at		$
2 Hrs. Chauffeur at 62½		$ 1.25
8 Hrs. Tapper at		$ 5.00
Hrs. Labor at		$
Hrs. Labor at		$
Hrs. Compressor at		$
Compensation Ins.		$ .19
Trucking		$ 1.00
Builders Use of Water Patch (Sewer)		$ 2.50
		$
		$
Ed Hesse		$
		$ 21.26

8 8 – 1937

Robertson St. ~~Pl.~~ ~~Ave.~~ No. 5

Name of Owner

Wabaunty

Labor and Mat'l. Report Aug 8, 1937

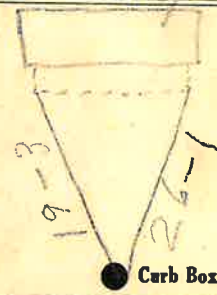

TAX ID # 309.7-12-26

6 Main — Elev. of Main at tap 5

Gate at • — • Gate at

• Curb Box

3/4" COPPER
28' TO MAIN
NEW HOUSE