LABOR AND MATERIALS

1	Copper ~~Lead~~ Connection	3/4	$ 1.79
1	Curb { Clock / Valve / ~~T. S. & V.~~ }	3/4 in.	$ 2.61
1	Service box Old returned { Short 3½X4½ / ~~Long 4½X5½~~ / ~~Buff or Rdway~~ }		$ 1.82
30'	Ft. 3/4 in. { Copper / ~~Galv. Iron~~ / ~~Cast Iron~~ }	Pipe at 23	$ 6.90
....	Nipples .... in. at		$ ....
....	Bushings .... to .... in. at		$ ....
....	Red'g / Inc'g Couplings .... to .... in. at		$ ....
....	Union .... in. at		$ ....
....	Meter .... in. at		$ ....
....	Lead Joints at		$ ....
....	Compound Joints at		$ ....
12	Hrs. ~~Foreman~~ at W&M - 92½		$ 11.10
4	Hrs. Chauffeur at 82½		$ 3.30
....	Hrs. Tapper at		$ ....
12	Hrs. Labor at 71½		$ 9.78
....	Hrs. Labor at		$ ....
....	Hrs. Compressor at		$ ....
....	Compensation Ins.		$ .39
....	Trucking		$ 1.—
....	Builders Use of Water		$ 5.—
Tapping Valve			$ ....
			$ ....
			$ ....
			$ ....
			$ 33.69

✓

62 - 46

✓

St. ~~Pl.~~ ~~Ave.~~ No. 8

Rogers

Name of Owner

Chenier

Labor and Mat'l. Report July 26 1946

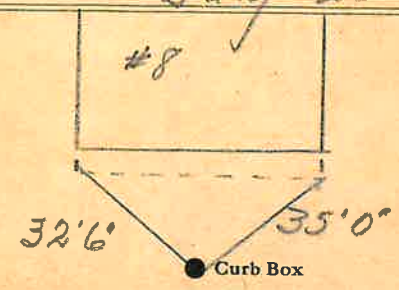

6 Main

Elev. of Main at tap 4½

Gate at ● ● Gate at

TAX ID # 303.18-15-13

● Curb Box

3/4" - 30' COPPER

LSM-5C-6-1-45