LABOR AND MATERIALS

1 Copper / Lead — Connection 3/4" — $
1 Curb — Cock / Valve / ~~T.S. & V.~~ 3/4 in. — $
1 Service box — Old returned — {Short 3½ x 4½ / ~~Long 4½ x 5½~~ / ~~Buff or Rdway~~} — $
28 Ft. 3/4 in. — {Copper / ~~G.I.~~ / ~~C.I.~~} Pipe at — $
Nipples ____ in. at ____ — $
Bushings ____ to ____ in. at ____ — $
Red'g / Inc'g Coupl'gs ____ to ____ in. at ____ — $
Union ____ in. at ____ — $
Meter ____ in. at ____ — $
Lead Joints at ____ — $
Compound Joints at ____ — $
Maintenance Foreman ____ — $
Hrs. Water Maint. Man—1 at ____ — $
Hrs. Water Maint. Man—2 at ____ — $
Hrs. Garage Foreman ____ at ____ — $
Hrs. Labor— ____ at ____ — $
Hrs. Compressor at ____ — $
Compensation Ins. at $ ____ per C — $
Trucking ____ — $
Pav't Patch ____ — $
Tap by Gisgerdt Co. 6-28-62. — $
____ — $
____ — $
O'head ____ — $

St. Pl. Ave. No. Rogers 12

Name of Owner
Francis West.

Labor and Mat'l. Report June 27 1962

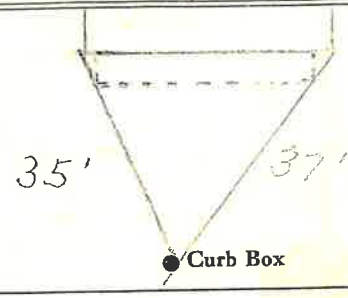

6" C.I. Main — Elev. of Main at tap 14'

Gate at ● ● Gate at

TAX ID # 303.18-15-11

● Curb Box

3/4" - 28' COPPER

LSM—5C—3-10-61