LABOR AND MATERIALS

1	Copper / ~~Lead~~ Connection	3/4	$ 1.23
1	Curb { Cock / Valve / T. S. & V. }	3/4 in.	$ 1.68
1	Service Box Old returned { Short 3½x4½ / Long 4½x5½ / Buff. or Rdway }		$ 1.75
9 Ft.	3/4 in. { Copper / ~~Galv Iron~~ / ~~Cast Iron~~ }	Pipe at .15	$ 1.35
	Nipples in. at		$
	Bushings to in. at		$
	Red'g / Inc'g Couplings to in. at		$
	Union in. at		$
	Meter in. at		$
	Lead Joints at		$
	Leadite Joints at		$
	Hrs. Foreman at		$
5	Hrs. Chauffeur at .62½		$ 3.13
	Hrs. Tapper at		$
	Hrs. Labor at		$
	Hrs. Labor at		$
	Hrs. Compressor at		$
	Compensation Ins.		$ .10
	Trucking t		$ 1.—
	Builders Use of Water no patch		$
Tap by Miller			$
			$
			$
			$
			$ 10.24

~~St.~~
Roosevelt ~~Pl.~~ Ave. No. 4

Name of Owner

Griffin

Labor and Mat'l. Report Nov 26 1935

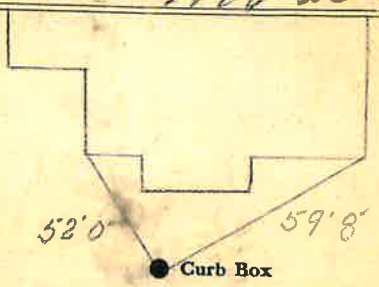

1 Main — Elev. of Main at tap 5

Gate at ● ● Gate at

TAX ID # 302.19-29-3

● Curb Box

3/4" - 9' COPPER

New House