LABOR AND MATERIALS

1	Copper Lead — Connection	3/4	$ 2.80
1	Curb — Clock Valve T. S. & V.	3/4 in.	$ 3.60
1	Service box Old returned — Short 3½X4½ / Long 4½X5½ / Buff or Rdway		$ 5.80
11	Ft. 3/4 in. — Copper / Galv. Iron / Cast Iron — Pipe at 35		$ 3.85
	Nipples ... in. at		$
	Bushings ... to ... in. at		$
	Red'g / Inc'g Couplings ... to ... in. at		$
	Union ... in. at		$
	Meter ... in. at		$
	Lead Joints at		$
	Compound Joints at		$
	Hrs. Foreman at		$
7	Hrs. Chauffeur at	91	$ 6.37
	Hrs. Tapper at		$
16	Hrs. Labor at	80	$ 12.80
	Hrs. Labor at		$
	Hrs. Compressor at		$
	Compensation Ins.		$ .42
	Trucking		$ 1.—
	Builders Use of Water		$ .80
	Tap 4 Warren Ave		$
			$
			$
			$
			$ 44.42

120-47

St. Pl. Ave. No. 23 Saganore

Name of Owner

Goulding

Labor and Mat'l. Report Aug 25 1947

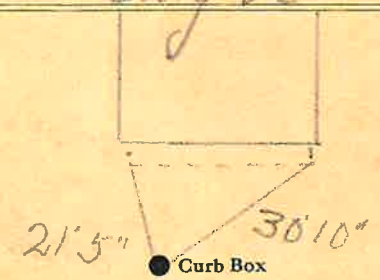

4 Main — Elev. of Main at tap 4

Gate at ● ● Gate at

TAX ID # 303.13-9-15

● Curb Box

11' to main
3/4" COPPER

LSM-5C-6-1-45