## LABOR AND MATERIALS

| | | | |
|---|---|---|---|
| 1 | Copper ~~Lead~~ Connection | 3/4 | $ 1.23 |
| 1 | Curb Cock / Valve / T. S. & V. | 3/4 in. | $ 1.68 |
| 1 | Service Box Old returned Short 3½x4½ / Long 4½x5½ / Buff. or Rdway | | $ 1.75 |
| 12 | Ft. 3/4 in. Copper / Galv Iron / Cast Iron Pipe at 15 | | $ 1.80 |
| | Nipples ____ in. at | | $ |
| | Bushings ____ to ____ in. at | | $ |
| | Red'g / Inc'g Couplings ____ to ____ in. at | | $ |
| | Union ____ in. at | | $ |
| | Meter ____ in. at | | $ |
| | Lead Joints at | | $ |
| | Leadite Joints at | | $ |
| | Hrs. Foreman at | | $ |
| 3 | Hrs. Chauffeur at | .62½ | $ 1.88 |
| | Hrs. Tapper at | | $ |
| 8 | Hrs. Labor at | .45 | $ 3.60 |
| | Hrs. Labor at | | $ |
| | Hrs. Compressor at | | $ |
| | Compensation Ins. | | $ .17 |
| | Trucking | | $ 1.00 |
| | Builders Use of Water | Patch | $ 5.00 |
| | Taphy Penon | | $ |
| | | | $ |
| | | | $ |
| | | | $ |
| | | | $ 18.11 |

4 5 - 1938

St.
Pl.
Sanford Ave. No. 208

Name of Owner

Hart

Labor and Mat'l. Report July 20 1938

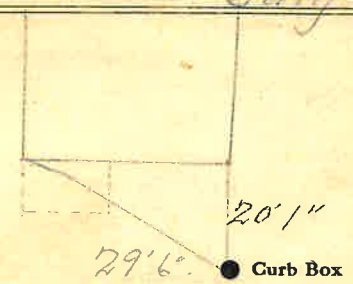


TAX ID # 303.9-7-37

6" Main

Elev. of Main at tap 4

Gate at ● ● Gate at

● Curb Box

12' to MAIN
3/4" COPPER

Neuchouse