LABOR AND MATERIALS

1	Copper / ~~Lead~~ Connection 3/4		$ 1.78
1	Curb { Clock / ~~Valve~~ / T. S. & V. } 3/4 in.		$ 2.61
1	Service box / Old returned { Short 3½X4½ / ~~Long 4½X5½~~ / Buff or Rdway }		$ 1.82
21	Ft. 3/4 in. { Copper / ~~Galv. Iron~~ / Cast Iron } Pipe at 23		$ 4.83
	Nipples in. at		$
	Bushings to in. at		$
	Red'g / ~~Inc'g~~ Couplings to in. at		$
	Union in. at		$
	Meter in. at		$
	Lead Joints at		$
	Compound Joints at		$
	Hrs. Foreman at		$
	Hrs. Chauffeur at		$
9	Hrs. Tapper at	75	$ 6.75
10	Hrs. Labor at	65	$ 6.50
	Hrs. Labor at		$
	Hrs. Compressor at		$
	Compensation Ins.		$ 36
	Trucking		$ 1.00
	Builders Use of Water Petch ?		$
	Tap by Maquinn		$
			$
			$
			$
			$ 25.65

Sanford St. ~~Pl.~~ ~~Ave.~~ No. 253

Name of Owner

Crockwill

Labor and Mat'l. Report Apr 30 1946

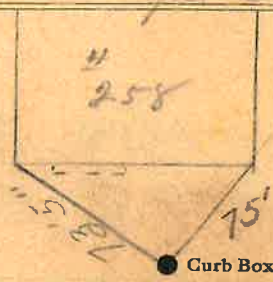

6 Main

Elev. of Main at tap 5

Gate at

21' to MAIN
3/4 COPPER

Gate at

Curb Box

For Studio

This tap is measure from 258 Sanford St

SM-5C-6-1-45