Labor and Materials

1	Copper / Lead	Connection 3/4	$ 1.46
1	Curb	Cock / Valve / T. S. & V. 3/4 in	$ 1.93
1	Service Box Old returned	Short 3½ x 4½ / Long 4½ x 5½ / Buff. or Rdway	$ 1.77
22	Ft. in.	Copper / Galv. Iron / Cast Iron Pipe at	$ 4.84
	Nipples in. at		$
	Bushings to in. at		$
	Red'g / Inc'g Couplings to in. at		$
	Union in. at		$
	Meter in. at		$
	Lead Joints at		$
	Leadite Joints at		$
	Hrs. Foreman at		$
1	Hrs. Chauffeur at		$ .63
½	Hrs. Tapper at		$ .31
8	Hrs. Labor at		$ 3.60
	Hrs. Labor at		$
	Hrs. Compressor at		$
	Compensation Ins.		$ .14
	Trucking		$ 1.–
	Builders Use of Water		$
			$
			$
			$
	Tap by [illegible]		$
			$ 15.68

128-1937

Sanford St. Pl. Ave. No. 42

Name of Owner

McKennedy

Labor and Mat'l. Report Oct 8 1937

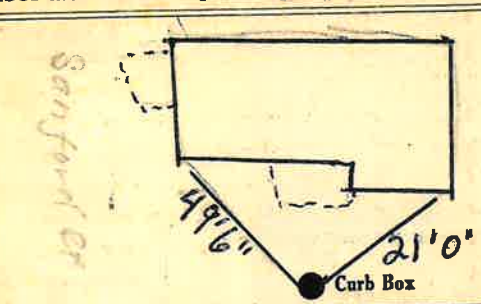

6 Main

Elev. of Main at tap 4'

Gate at • TAX ID # 302.16-5-34 • Gate at

● Curb Box

TAP ON Smith St.

old Shut off

Bill 22' to MAIN

3/4" COPPER