LABOR AND MATERIALS

1	Copper ~~Lead~~ Connection	3/4"	$ 3.04
1	Curb { Clock / ~~Valve~~ / ~~T. S. & V.~~ }	3/4 in.	$ 3.89
1	Service box Old returned { Short 3½X4½ / ~~Long 4½X5½~~ / ~~Buff or Rdway~~ }		$ 4.32
12	Ft. 3/4 in. { Copper / ~~Galv. Iron~~ / ~~Cast Iron~~ } Pipe at 45		$ 5.40
1	Nipples 2½X3/4" in. at Brass		$
	Bushings to in. at		$
1	Red'g Inc'g { Brass Couplings 3/4 to 1½ in. at		$
	Union in. at		$
	Meter in. at		$
	Lead Joints at		$ 37.63
	Compound Joints at		$
7	Hrs. Foreman at		$
7	Hrs. ~~Chauffeur~~ at 4 Men - 2.033		$ 14.23
	Hrs. Tapper at		$
18	Hrs. Labor at 1.30		$ 23.40
	Hrs. Labor at		$
	Hrs. Compressor at		$
	Compensation Ins. 5.196		$ 2.14
	Trucking		$ 1.50
	Builders Use of Water. Pavement		$ 5.04
	Tap by Lareau & Co 7-25-56		$
			$
			$
			$
			$

St. ~~Pl.~~ ~~Ave.~~ No. 48

Sanford

Name of Owner

King

Labor and Mat'l. Report July 25 1956

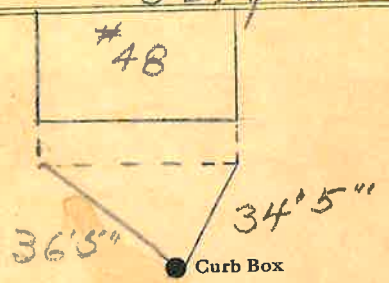

6" Main

Elev. of Main at tap 4'

Gate at ● ● Gate at

TAX ID# 302.16-6-26

● Curb Box

12' to main

3/4" copper

LSM-5C-6-1-45