Labor and Materials

1	Lead Connection 3/4"	$
1	Curb Cock 1"	$
1	Service Box Old returned { Short 3½ x 4½ / Long 4½ x 5½ / Buffalo	$
27	Ft. 1" in. G. I. Pipe at	$
	Nipples ..... in. at	$
	Bushings ..... to ..... in. at	$
	Red'g Coup .... to .... in. at	$
	Inc'g Coup .... to .... in. at	$
	Union .... in. at	$
	Meter .... in. at	$
	Cu. Yds. Br. Stone at	$
	Cu. Yds. Sand at	$
	Bags Cement at	$
	Paving Brick { Mack / Red / Asphalt } at	$
4	Hrs. Foreman at	$
7	Hrs. Common Labor at	$
	Hrs. Mason at	$
	Hrs. ..... at	$
	Hrs. ..... at	$
9	Builders' Use of Water	$
	..... at	$
	Truck 100 ..... at	$
	..... at	$
	..... at	$
	Total	$ 18.07

Labor and Material Report 1924

Apr 24

3/4" tap at ~~47~~ 69 Sanford st

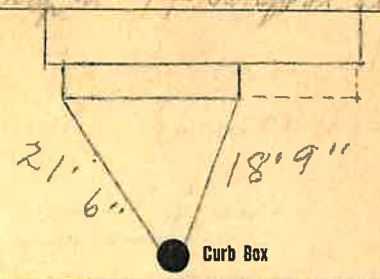

6" Main

Elev. of Main at tap 6'

Gate at ● ● Gate at

TAX ID # 302.16-13-23

● Curb Box

27' to MAIN

1" GAL.